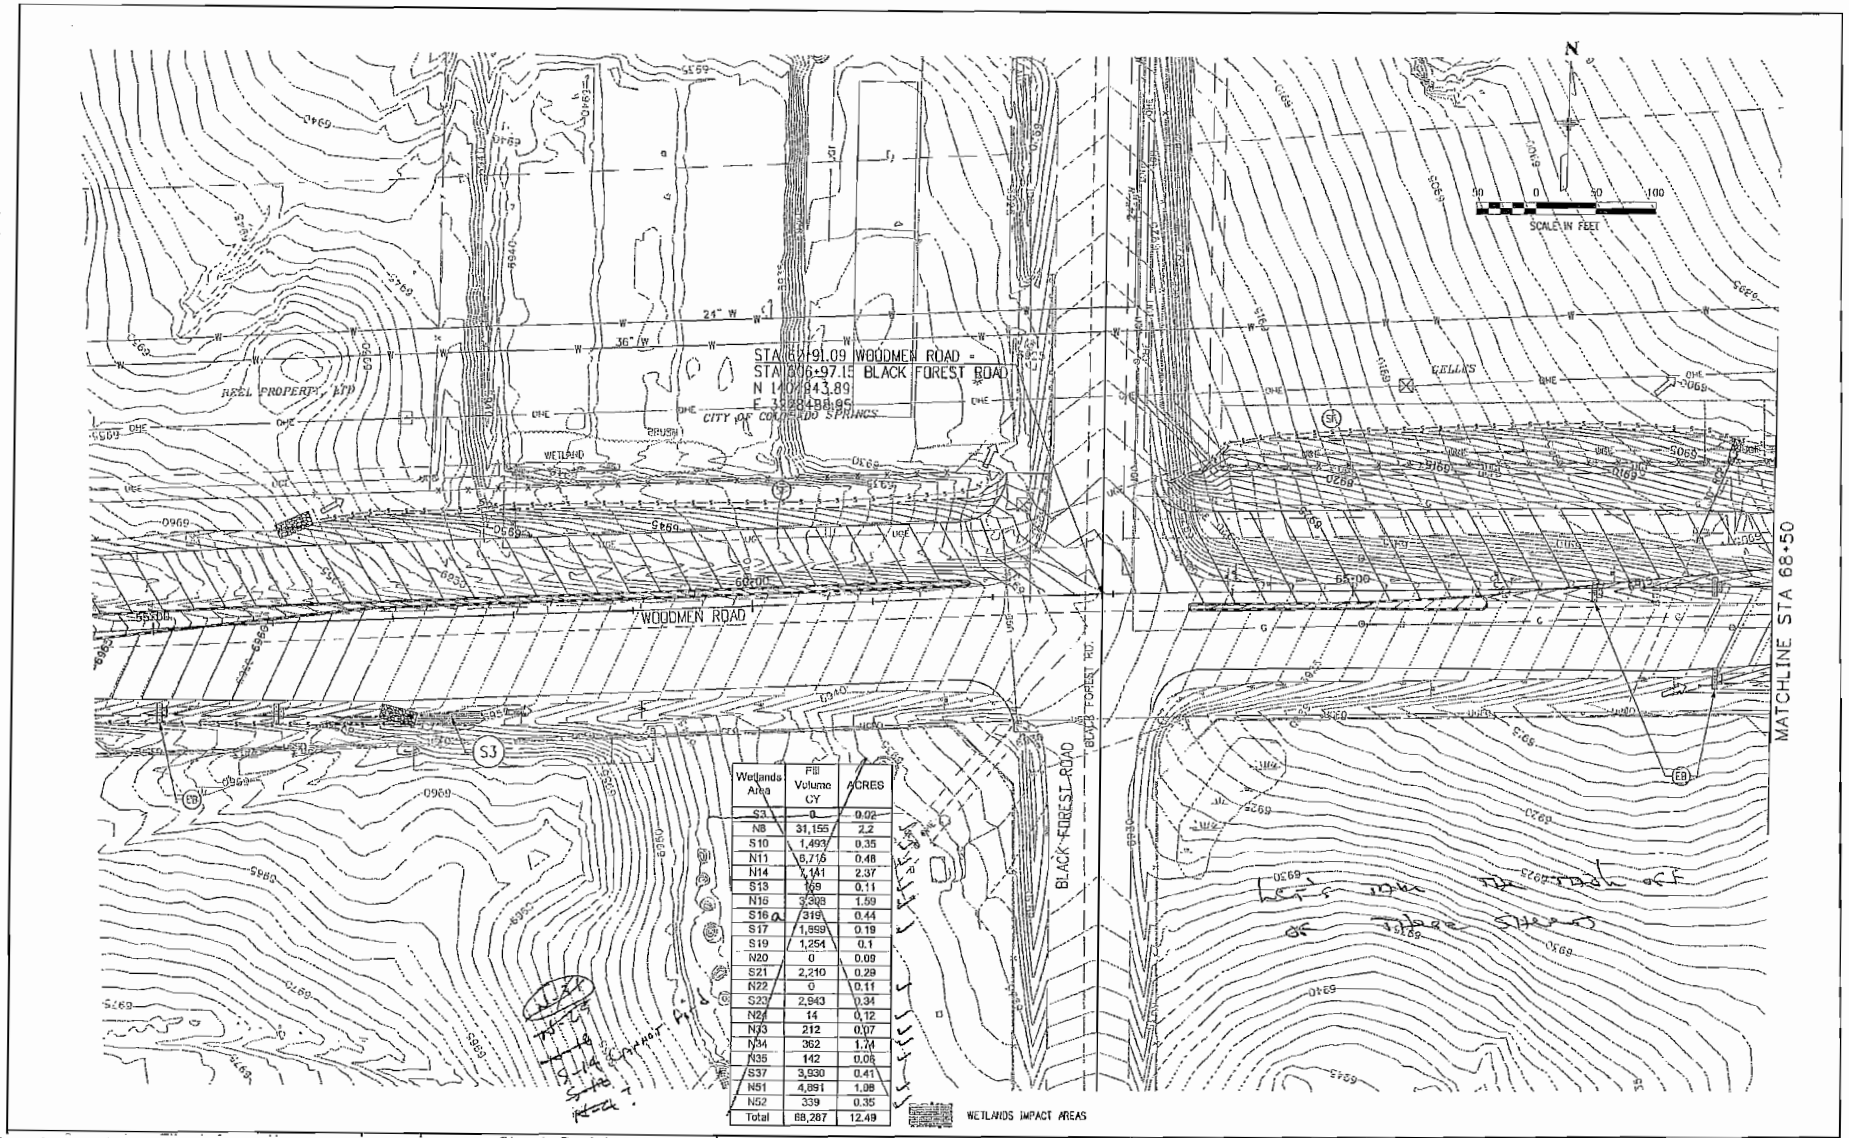

Wetlands Area	FB Volume CY	ACRES
S3	0	0.02
N8	31,155	2.2
S10	1,493	0.35
N11	6,716	0.48
N14	7,141	2.37
S13	169	0.11
N16	3,308	1.59
S16	319	0.44
S17	1,899	0.19
S19	1,254	0.1
N20	0	0.09
S21	2,210	0.29
N22	0	0.11
S23	2,943	0.34
N24	14	0.12
N33	212	0.07
N34	362	1.74
N35	142	0.06
S37	3,930	0.41
N51	4,891	1.08
N52	339	0.35
Total	68,287	12.49

Woodmen Road improvements in tributaries of Sand Creek and Black Squirrel Creek near Colorado Springs, El Paso County, Colorado
Application by: El Paso County Department of Transportation
Application No. SPA-2007-271
Sheet 4 of 20

May 18, 2007

DMJM HARRIS | AECOM
2950 Professional Place
Colorado Springs, Colorado 80904
Phone: (719) 366-6300 Fax: (719) 366-6338

EL PASO COUNTY DEPARTMENT OF TRANSPORTATION

As Constructed	WOODMEN ROAD	Project No./Code
No Revisions: –	WETLANDS IMPACT – PLAN	STU M240-062
Revised: –	Designer: SJM / Structure Numbers	13263
Void: –	Detailer: LPS	Sheet Number
	Sheet Subset: Wetlands / Subset Sheets: WT01 of 13	

FIGURE 3A